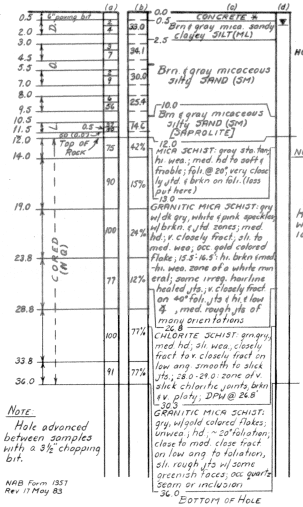

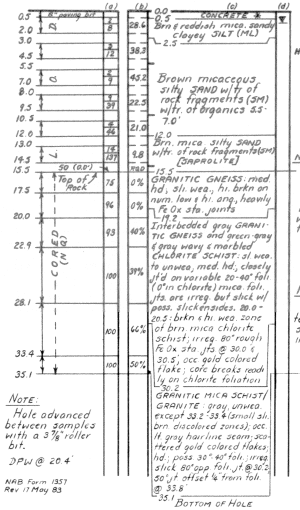

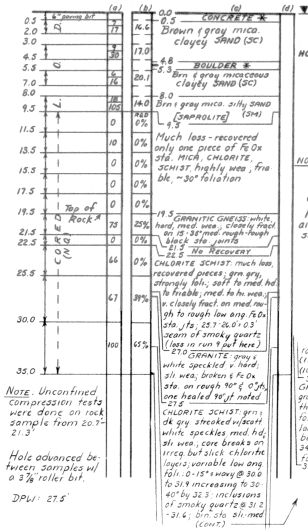

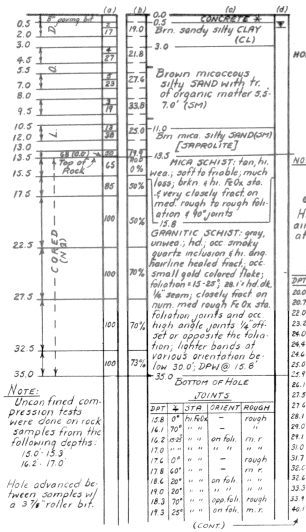

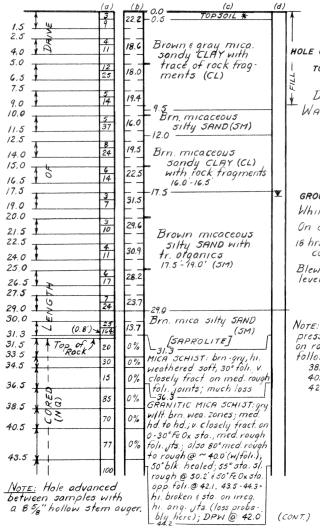

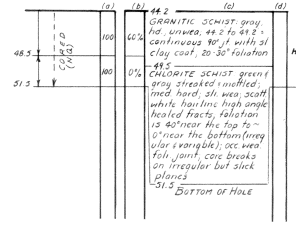

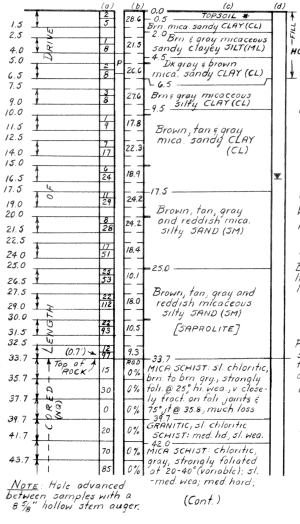

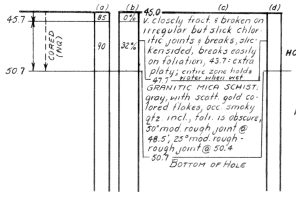

FOR INFORMATION ONLY

RECORD DRAWING AS-BUILT
OMNI CONTRACTORS, INC.

REV	DATE	DESCRIPTION	BY
	NOV '92	AS-BUILT	

US Army Corps of Engineers

U.S. ARMY ENGINEER DISTRICT, BALTIMORE
CORPS OF ENGINEERS
BALTIMORE, MARYLAND

WASHINGTON AQUEDUCT
DALECARLIA WATER TREATMENT PLANT
REPLACEMENT OF FLOC. & SED. BASINS NOS. 1 & 2
SUBSURFACE EXPLORATION LOGS

CIVIL

DRAWN BY: B.D.O.	DRAWING NUMBER	PLATE
TRACED BY: B.D.O.	40.8-3.10	10
CHECKED BY: B.D.O.		
SCALE NONE	DATE JUNE 1989	SHEET C-10 OF 15

SHEET 10 S-15